RECEIVED
By BCROSBY at 8:58 am, Mar 27, 2020

COFFIN & McLEAN ASSOC., INC.		CERTIFIED TO THE FOLLOWING ONLY:							
Professional Land Surveying		RIPA / O'DONNELL							
3701 Commercial Way		PASTORE CUSTOM BUILDERS							
P.O. Box 5145 Spring Hill, FL 34611-5145		DESCRIPTION: LOT 2, BLOCK 318, UNIT 5, ROYAL HIGHLANDS, according to the Plat thereof as recorded in							
OFFICE (352) 683-5993 F	Plat Book 12, Pages 45 - 59, inclusive of the Public Records of Hernando County, Florida.								
Party Chief: J. PAYNTER	W.O20-58SP					HYDE STREET KEY# 00719351			
Drawn By: D. WILLIAMS Chacked By: J.COFFIN	DATE: 02\20\2020	SECTION:7_TOWN	ISHIP: 22	S, RANGE: _	18 E				
MAP OF SURVEY, BC	F.B. 938 PG. 78-79	J							
AND SITE PLAN	ONDARY SORVEY	PLAT	LIMIT	FIR 1/2" 4678	101.7 ×				
AND STIE PLAN					5' CL	F .4 (NE)			
SITE PLAN MUST BE APPROVED BY COUNTY BUILDING DEPARTMENT									
D7 0001117 D0220.	ENO DEL MICHAELAT		/		1,1				
ZONING PERMIT Zoned R1C									
To be used asSF I		327 18 327 18	EASEMEN	₆ A98	`,	Wings Jor Browsh			
Checked By: SWC OUT BY THE STATE OF THE STAT									
				Lot 2. BLOCK 318		1 1/2			
130		I LEGICAL TO THE THE PARTY OF T	30.	LOT 2. BL	(ALSA	FIR 1/2" 4878	LF .15 (NE)		
1	18 5232					101.5			
*	STR IN					/// "			
\			23.00		./				
l de la companya della companya della companya de la companya della companya dell	Market Ma		911	to.	EMENT				
200	it soon for the	S The state was		19.	15 613				
3/25	A COURT AND			//					
\		18 18 1 1 1 1 1 1 1 1 1 1 1 1 1 1 1 1 1							
	E GER		/	18 288 55 Ab	CX 318				
	1 1 1 1 1 1 1 1 1 1 1 1 1 1 1 1 1 1 1	\	///	28, 44 E)	of 3 BLOU				
	Ref. Reg. See	14	5,500	b	POLICE .				
ALERT: This project may require Federal, State, or Local Authority permits. The applicant is solely responsible for obtaining all permits and authorizations from the responsible									
ALERT: This project may require Federal, State, or Local Authority permits. The applicant is solely responsible for obtaining all permits and authorizations from the responsible									
State, or Local Authority permits. The is solely responsible for obtaining all	applicant 2	The state of the s	25. 100 to		E CONSTRUC MENTS	CTED WITHIN			
and authorizations from the responsil	,	A STORY OF THE PROPERTY OF THE			/				
authorities. The issuance of this permit does not									
	i de la companya de l	THOSE STORY		/					
Residential driveways must co Hernando Cty Facility Design		1/2/3	6 18 PL	(Bright	50'	25' 0	50'		
Sec IV-26. It is the applicants	responsibility	*/	OO, TERESTON FOR	ARRITY AVE CRAIN	50	25' 0	50		
to verify compliance prior to c For information call 352-754-4			// /	MIRA		SCALE : 1" = 50'			
Se consequence and a second section of the second s	URVEYOR NOTES		•		CIT ATTOMAC		,		
Survey based on the description furnished by the a without benefit of a title search.		y be subject to the Rules,	AC Air Conditioner AGL Above Ground Le AGP Above Ground Po	ed FCM F	REVIATIONS LE				
Bearings shown hereon are assumed by this Survey Mapper in accordance with the Record Plat or Deed	or and State, and/or Federal Agencie and the Rules, Regulations, Ordinances	s. The requirements of said and/or the limits of said	ALUM Aluminum ASNS Aluminum Shed RLDG Ruilding		nished Floor ire Hydrant ound Iron Pipe ound Iron Rod	PPF Pool Pump & Filter PRM Permanent Refere PT Point of Tangency	ence Monument		
location of the line used for the **BASIS FOR BEA depicted by ** next to the bearing. 3. Underground utilities and improvements not locate	otherwise		8M Benchmark BWF Barbed Wire Fen C Calculated from Rec	ce Fnc. I ord Information FND.	Found	PVMT Povement R Record Plat or Des RCP Reinforced Concre RNB Range RFZ Reduced Pressure R/W Right of Way SCE Screened Coveres SEC Section SECP Screened Enclose	d ete Pipe		
shown. 4. There are no visible encroachments unless shown h	ereon. the County Building Department verification of Flood Zone.	nt should be contacted for	C1 Curve #1 CATV Cable Television CB Catch Basin CBS Concrete Block St	Box 6P 60	Suy Wire Hog Wire Fence Trigation Valve box Invert Ine #1	RPZ Reduced Pressure R/W Right of Way SCE Screened Coverer SEC Section	Zone d Entry		
 The ownership of fences, if any, which exist on or property lines is not known by this Surveyor and M. Fences located near the property line are not to so 	apper. utilities unless shown otherwis	se.	CE Covered Entry O.F. Chain Link Fence	IGV I INV	rrigation Valve box Invert ne #1	SECP Screened Enclose SES Screened Enclose SIR Set Iron Rod	ed Concrete Pool ed Slab		
distances shown as ties to said fences are correct. 7. The distances shown hereon as ties to existing occ	Restrictions and Fasements o	f Record and not of Record.	CM Concrete Monume CMP Corrugated Metal CONC Concrete CPP Concrete Powerpo CW Concrete Walk	I Pipe LP Lis	nd Surveyor Business ght Pole and Surveyor Mitered End Section	SECV Screened Enclose SES Screened Enclose SIR Set Iron Rod SIS Sewer in Street SP Screen Porch TBM Temporary Bench TOB Top of Bank TOE Top of Slope TRANS Transformer	h Mark		
are at right angles to subject property line. 8. Gutters, overhangs, underground foundations and in systems are not located unless shown hereon.	rrigation Measurement unless otherwise Perpendicular Ties.	e shown and are	CW Concrete Walk D Deed DI Drop Inlet DRA Drainage Retentio	MH /	Wanhole North American Vertical Datum	TOE Top of Slope TRANS Transformer TWP Township			
THIS CERTIFIES THAT A SURVE	DROW Drainage Right- EB Electric Box EL Elevation	of-way OE O	No climb rence National Geodetic Vertical Data Nerhead Electric Wine Official Record at Book	WFSNS Wood Frome WFSOS Wood Frome	wer Service Shed No Slab Shed On Slab				
WAS MADE UNDER MY SUPERVISION AND THAT THE SURVEY MEETS THE STANDARDS OF PRACTICE SET FORTH BY THE FLORIDA BOARD OF			EP Edge of pavement F Derived from Field i FB Field Book FCIP. Found Capped	Measurement PC PC PC PC PCB F PCB F PCC P	of Book oint of Curvature oint of Intersection Point of Beginning oint of Commencement	BIRANS Ironsformer TWP Township TYP Typical Une Sunderground Po WFSNS Wood Frame WFSOS Wood Frame WM Water Meter WO Work or often WR Wood Rail Fence WR Wood Rail Fence WW Wood Frame WR For Solve WR Follow			
PROFESSIONAL SURVEYORS AND MAPPERS IN CHAPTER 5J-17 (FORMERLY 61G17-6) FLORIDA ADMINISTRATIVE CODE, PURSUANT TO SECTION 472.027,			F.C.I.P. Found Capped F.C.I.R. Found Capped	Iron Rod PP Po	wer Pole ROL & CORNE	10 10 0 10 1			
FLORIDA STATUTES. AND, THAT THE MAP HEREON IS A TRUE AND ACCURA REPRESENTATION THEREOF, TO THE BEST OF MY KNOWLEDGE AND BELIEF			O Set 5/8"	Iron Rod LB# 52		☐ Set 4" × 4" C.I	M. LS# 3882		
SUBJECT TO NOTES AND NOTA	DOE AIND BELLET.		wn Refer to:	NGVD 1929 2020\20-58\20-58-5F		sumed Datum. ED: 02/20/20			
() . 1	\mathcal{O}		Flood Plane Certi	ification:	REVISIONS		DATE		
FAMES W. COFFIN,		02/18/2020 DATE OF	According to the Community Panel Dated:02-02-13	: 12053C 0158 D	BOUNDARY SU	RVEY & SITE PLAN	02/20/20		
Professional Surveyor & Mapper	ι	AST FIELD WORK	This property ap	pears to be in					
Florida Registration # 3882 Coffin & McLean Assoc., Inc. LB #5	5232		Base Flood Elevat						
UNLESS IT BEARS THE SIGNATURE AND THE ORIGINA	AL RAISED SEAL OF A FLORIDA LICENSED SU	RVEYOR AND MAPPER,	FILE : 20-58.CR	5		F	PAGE 1 OF 1		

COFFIN & McLEAN ASSOC., INC.

Professional Land Surveying 3701 Commercial Way P.O. Box 5145

Spring Hill, FL 34611-5145

OFFICE (352) 683-5993 FAX (352) 683-9156

OI I TOLI (G	02) 000 0000	1111 (000) 000 0100			
Party Chief:	J. PAYNTER				
Drawn By:	C. COFFIN	DATE: 02\20\2020			
Checked By:	J.COFFIN	F.B. 938 PG. 78-79			

CERTIFIED TO THE FOLLOWING ONLY:

SASHA RIPA BRANNEN BANK ALL PERFORMANCE TITLE, INC. / WESTCOR LAND TITLE INSURANCE COMPANY PASTORE CUSTOM BUILDERS

DESCRIPTION:

LOT 2, BLOCK 318, UNIT 5, ROYAL HIGHLANDS, according to the Plat thereof as recorded in Plat Book 12, Pages 45 - 59, inclusive of the Public Records of Hernando County, Florida.

> 11320 HYDE STREET Parcel KEY# 00719351

SECTION: __7_TOWNSHIP:

__22__ s, RANGE:

MAP OF SURVEY, BOUNDARY SURVEY FIR 1/2" 4678 PLATLIMIT AND SITE PLAN FOR OUT BUILDINGS 5' CLF .4 (NE) ZONING PERMIT Zoned R1C To be used as DET.GARAGE Checked By: CDG ALERT: This project may require Federal, State, or Local Authority permits. The applicant is solely responsible for obtaining all permits and authorizations from the responsible LOT 2. BLOCK 318 authorities. The issuance of this permit does not negate any other agency permit requirements. 5' CLF 0.15 (NE) NOTICE: NO STRUCTURES, BUILDINGS, OR IMPROVEMENTS CAN ENCROACH OR BE CONSTRUCTED WITHIN **EASEMENTS** 25' 50

SURVEYOR NOTES

- Survey based on the description trurismed by the client and without benefit of a title search. Bearings shown hereon are assumed by this Surveyor and Mapper in accordance with the Record Plat or Deed and the location of the line used for the "BASIS FOR BEARINGS is depicted by "mext to the bearing. Underground utilities and improvements not located or

- Underground utilities and improvements not receive to shown. There are no visible encroachments unless shown hereon. The ownership of fences, if any, which exist no or near property lines is not known by this Surveyor and Mapper. Fences located near the property line are not to scale. The distances shown as ties to said fences are correct. The distances shown hereon as ties to existing occupation are at right angles to subject property line. Getters, overhange, underground forundations and irrigation systems are not located unless shown hereon.
- Survey based on the description furnished by the client and without benefit of a title search.
 Bearings shown hereon are assumed by this Surveyor and Mapper in accordance with the Record Plat or Dead and the location of the line and for the "PBASIS FOR BEARINGS is depicted by "in exit to the bearing.

 Resident of the "The exit to the bearing.

 **The property shown heron may be subject to the Rules, Regulations, Ordinances and/or Turnisdictions of Local, State, and/or Federal Agencies. The requirements of said Jurnisdictions are not shown hereon, unless stated otherwise.

 **The property shown heron may be subject to the Rules, Regulations, Ordinances and/or Turnisdictions of Local, State, and/or Federal Agencies. The requirements of said Jurnisdictions are not shown hereon, unless stated of the limits of said Jurnisdictions are not shown hereon, unless stated of the limits of said Jurnisdictions are not shown hereon, unless stated of the limits of said Jurnisdictions are not shown hereon, unless stated of the limits of said Jurnisdictions are not shown hereon, unless stated of the limits of said Jurnisdictions are not shown hereon, and the said of the limits of said Jurnisdictions are not shown hereon, unless stated of the limits of said Jurnisdictions are not shown hereon, unless stated of the limits of said Jurnisdictions are not shown hereon, and the said of the limits of said Jurnisdictions are not shown hereon.
 - otherwise.

 10. Prior to construction and/or reliance on Flood Zone Note, the County Building Department should be contacted for verification of Flood Zone.

 11. All easements shown hereon are for drainage and/or utilities unless shown otherwise.

 12. The property shown heron is subject to Reservations, Restrictions, and Ecumental of Record and not of Record.

The Ties to Property Lines are Calculated from Field Measurement unless otherwise shown and are Perpendicular Ties.

THIS CERTIFIES THAT A SURVEY OF THE PROPERTY DESCRIBED HEREON. WAS MADE UNDER MY SUPERVISION AND THAT THE SURVEY MEETS THE STANDARDS OF PRACTICE SET FORTH BY THE FLORIDA BOARD OF PROFESSIONAL SURVEYORS AND MAPPERS IN CHAPTER 5J-17 (FORMERLY 61G17-6) FLORIDA ADMINISTRATIVE CODE, PURSUANT TO SECTION 472.027, FLORIDA STATUTES. AND, THAT THE MAP HEREON IS A TRUE AND ACCURATE REPRESENTATION THEREOF, TO THE BEST OF MY KNOWLEDGE AND BELIEF. SUBJECT TO NOTES AND NOTATIONS SHOWN HEREON.

SAMES W. COFFIN. Professional Surveyor & Mapper Florida Registration # 3882

02/18/2020 DATE OF

LAST FIELD WORK

COFFIN & MCLean Assoc., Inc. LB #5232

UNLESS IT BEAS THE SIGNATURE AND THE ORIGINAL RAISED SEAL OF A FLORIDA LICENSED SURVEYOR AND MAPPER, THIS DRAWING, SKETCH, PLAT, OR MAP IS FOR INFORMATIONAL PURPOSES ONLY AND NOT VALID.

ABBREVIATIONS LEGEND

- Deed Drop Inlet I Droinage Re
- UKA Drainage Retention Area DROW Drainage Right-of-way EB Electric Box EL Elevation EP Edge of pavement F Derived from Field Measure FB Field Book F.C.I.P. Found Copped Iron Pipe F.C.I.R. Found Copped Iron Rod
- ABBREVIATIONS L
 FCM Faud Gozette Munuter
 FF Freished Floor
 FH Freished
 FH Freished
 FH Freished
 FH Floor
 FH Floo
- NCF No Climb Fence
 NSVD National Geodetic Vertical Dat
 OE Overhood Electric Wire
 OR, Official Record
 PB Plat Book
 PC Point of Curvature
 PI Point of Curvature
 PI Point of Curvature
 PC Point of Commencement
 PO Power Pola
- PPF Pool Pump & Filter
 PRM Permanent Reference Me
 PT Point of Tangency
 PVMT Powement
 R Record Plat or Deed
 RCP Reinforced Concrete Pipe
 RNG Range
 RPZ Reduced Pressure Zone
 R/W Right of Way
 SCF Screened Coveral Entry SCE Screened Covered Entry SEC Section SECP Screened Enclosed Conc SES Screened Enclosed Slab SIR Set Iron Rod SIS Sewer in Street SP Screen Porch SALS Saver in Street

 FS Screen Port

 TBM. Temporary Bench Mark

 TBM. Temporary Bench Mark

 TDB. Top of Stope

 WFSOS Wood Frome Shed On Stob

 WW. Water Marco Shed

 WW. Water Marco Shed

 WW. Water Marco Shed

 WW. Water Marco Shed

 TDB. Top of Stope

 WW. Water Marco Shed


 TDB. Top of Stope

 TDB. Top

SCALE: 1" = 50'

CONTROL & CORNER LEGEND

O Set 5/8" Iron Rod LB# 5232 Set 4" x 4" C.M. LS# 3882 Elevations Shown Refer to: NGVD 1929 □ NAVD 1988 ☑ Assumed Datum. OFFICE USE ONLY: C:\DRAWING\DWG\2020\20-58\20-58SP2.DWG LAST PLOTTED: 09/14/20 Flood Plane Certification:
According to the F.I.R.M. Map,
Community Panel: 12033C 0158 b
Dated: 02-02-12
This property appears to be in
Flood Zone "X" ... NONE REVISIONS DATE BOUNDARY SURVEY & SITE PLAN 02/20/20 08/11/20 SITE PLAN FOR OUT BUILDINGS 09/14/20 Flood Zone _"X" .
Base Flood Elevation : ____NONE Datum: N/A FILE: 20-58.CR5 PAGE 1 OF 1

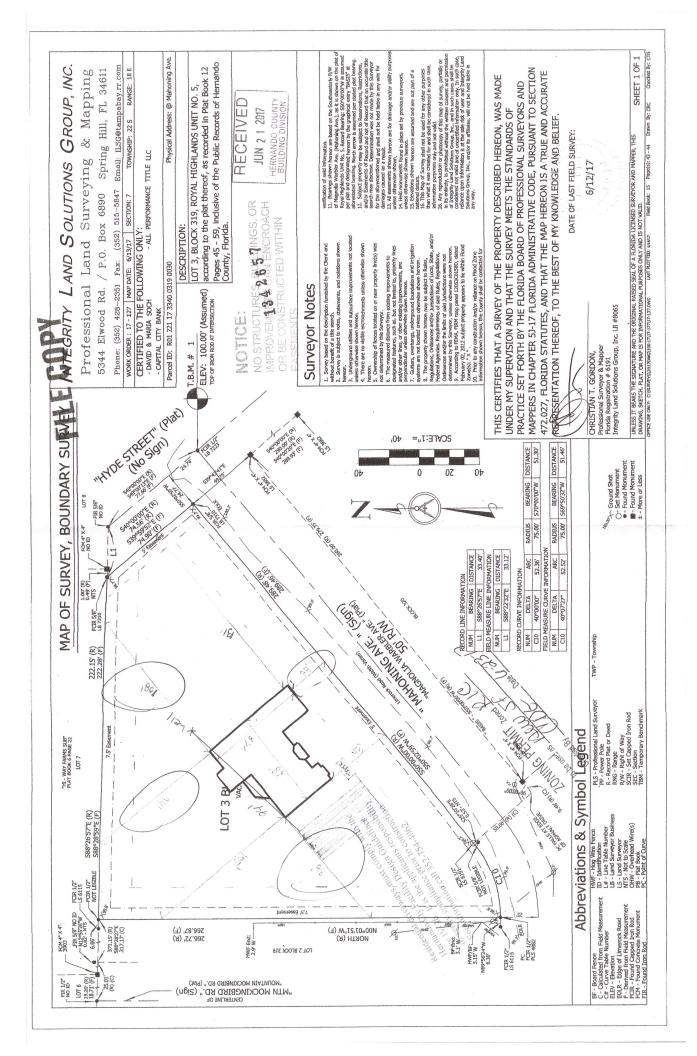

COFFIN & McLEAN ASSOC., INC.

Professional Land Surveying 3701 Commercial Way P.O. Box 5145 Spring Hill, FL 34611-5145

(352) 683-5993 FAX = (352) 683-9156

Party Chief:		W.O	23-175	
Drawn By: _ Checked By:	J.COFFIN	DATE:	05\02\23	
	J.COFFIN		PG	


CERTIFIED TO THE FOLLOWING ONLY:

DESCRIPTION: A portion of Hyde St. between Lat 3, Block 319 and Lat 1, Block 318 of Rayal Highlands Unit 5, according to the Plat thereof, acreared de in Plat Book 12, Pages 45-59, of the Public records of Harmand County, Florida Being more particularly described as follows: Beginning at the SE conner of said Lot 3, Block 319, thence N40° 00'00'W, olong the Easterly boundary, line of said Lot 3, Block 319, distance of 7.65 feet to the Corner of said Lot 3, Block 319, thence S80°26'57"E, a distance of 6.6.81 feet to the NW corner of Lot 1, Block 318 of said Unit 5; thence S40°00'00'W, along the Westerly property line of said Lot 1, Block 318, a distance of 30.24 feet, thence S50°00'00'W, a distance of 50.00 feet to the Point of Beginning.

SECTION 7 TOWNSHIP: 22 5, RANGE 18 E

MAP OF SURVEY, SKETCH FOR LEGAL DESCRIPTION

HIGHWAY FARMS SUR PLAT BOOK 5, PAGE 22 KEY # 103881

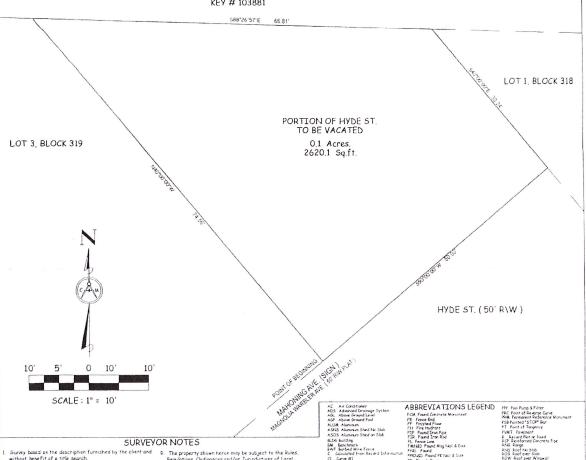

SURVEYOR NOTES

- SURVEY.

 Survey based on the description furnished by the client and without benefit of a title search.

 Bearings show hereon are assumed by this Surveyor and Mapper in accordance with the Record Plat or Deed and the location of the line used for the "BASTS FOR BEARTING" is depicted by ""next to the bearing.

 Underground utilities and improvements not located or show.

 There are no widely come.
- undergrows utruines and improvements for located or shown. There are no wisible encreachments unless shown herean. Theowership of fences, if any, which exist one near property lines is not known by this Surveyer and Mapper. Fences losated near the property line are not to stall. The distances shown as ties to said fences are correct. The distances shown hereans these to existing occupation are at right angles to subject property line. Gutters, overhapps, underground faundations and irrigation systems are not located unless shown herean.

- YOR NOTES
 9. The property shown herein may be subject to the Rules, Regulations, Ordinances and/or Jurisdictions of Local, State, and/or Federal Agencies. The requirements of Sould Jurisdictions are not shown herean, unless stated of Jurisdictions are not shown herean, unless stated otherwise.
 10. Prior to construction and/or reliance on Flood Zone Note, the County Soulding Department should be cereated for verifications of Flood Zone and for verifications of Flood Zone are for drainage and/or undities unless shown otherwise.
 2. The property shown here is subject to Reservations, Restrictions, and Exements of Record and not of Record.
 3. THE TEST OF DEPORTED LINES AND EXCIPLIANT EXPENDING.

- 13. THE TIES TO PROPERTY LINES ARE CALCULATED FROM FIELD S
 MEASUREMENT UNIESS OTHERWISE SHOWN AND ARE
 PERPENDICULAR TIES

THIS CERTIFIES THAT A SURVEY OF THE PROPERTY DESCRIBED HEREON, WAS MADE UNDER MY SUPERVISION AND THAT THE SURVEY MEETS THE STANDARDS OF PRACTICE SET FORTH BY THE FLORIDA BOARD OF PROFESSIONAL SURVEYORS AND MAPPERS IN CHAPTER 5J-17 (formerly 61G17-6) FLORIDA ADMINISTRATIVE CODE, PURSUANT TO SECTION 472.027 FLORIDA STATUTES, AND, THAT THE MAP HEREON IS A TRUE AND ACCURATE REPRESENTATION THEREOF, TO THE BEST OF MY KNOWLEDGE AND BELIEF SUBJECT TO NOTES AND NOTATIONS SHOWN HEREON.

10H JAMES W. COFFIN, Professional Surveyor & Mapper Florida Registration # 3882 Coffin & McLean Assoc., Inc. LB #5232

NIA DATE OF LAST FIELD WORK

Milk Sechniser, Francis Consideration Francis Consideration Francis Consideration Francis Consideration Francis Franci

ABBREVIATIONS LE
FOR Fand Control Memotives
FOR Fand Control Memotives
FOR Fand Control Memotives
FOR Fand Fand
FOR FAND

VF Vimflence
WIDF Weed Force
WIDF Sed Force
WIDFS Wood Frome Shed No Side
WIDFS Wood Frome Shed Cin Side
WAL Water Marter
WO Work order
WOF Weed Rail Force
WIDF Weed Rail Force
WIDF Weed Rail Force
WIDF Weed Rail Force
WIDF Weed Force
M. Yand Inmie

CONTROL & CORNER LEGEND

 Set 5/8" Iron Rod LB# 5232 Elevations Shown Refer to: NSVD 1929 | NAVD 1988 | Assumed Datum, FFICE USE ONLY | C\tag{NSVD 1923 | NAVD 1988 | LAST FLOTTED | 05/08/23 05/08/23 Flood Place Certification:
According to the F.T.R.M. Map.
Community Panel: 12653C 0156 D
Dated: 02 02 12
This property appears to be in
Flood Zone X
Base Flood Elevation: NONE
Datum: NONE REVISIONS DATE SKETCH FOR LEGAL 05/08/23